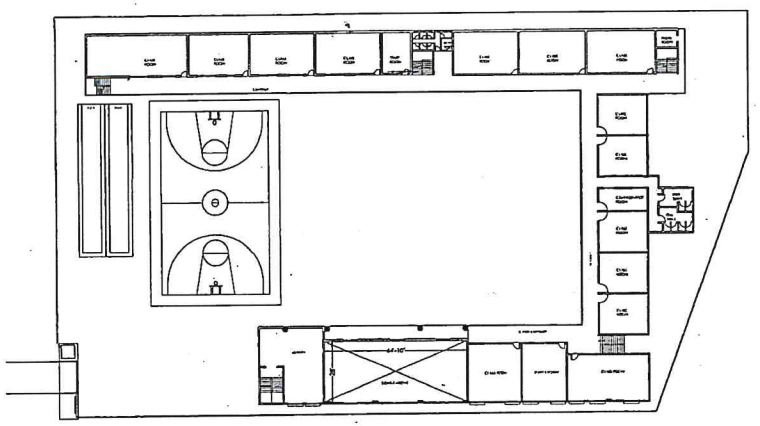

02 FIRST FLOOR PLAN
SCALE: NTS

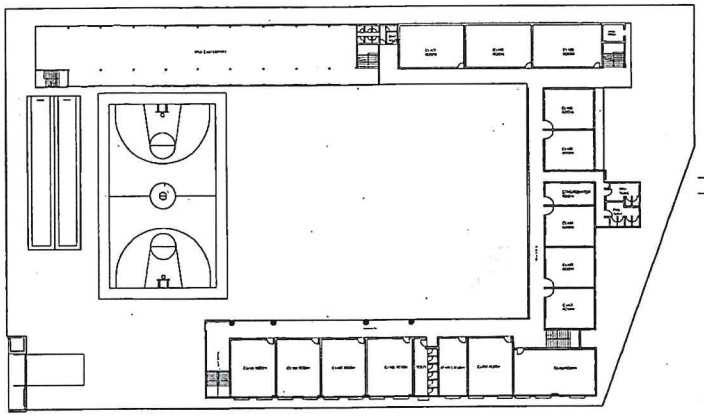

04 THIRD FLOOR PLAN
SCALE: NTS

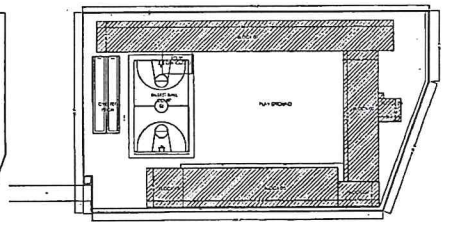

05 SITE PLAN
SCALE: NTS

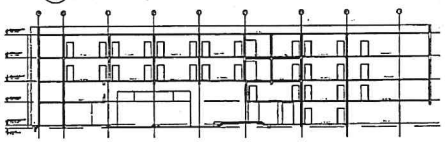

06 SECTION
SCALE: NTS

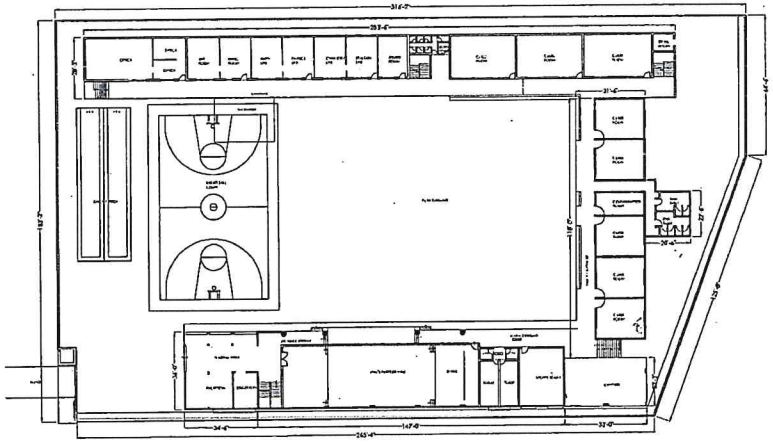

01 GROUND FLOOR PLAN
SCALE: NTS

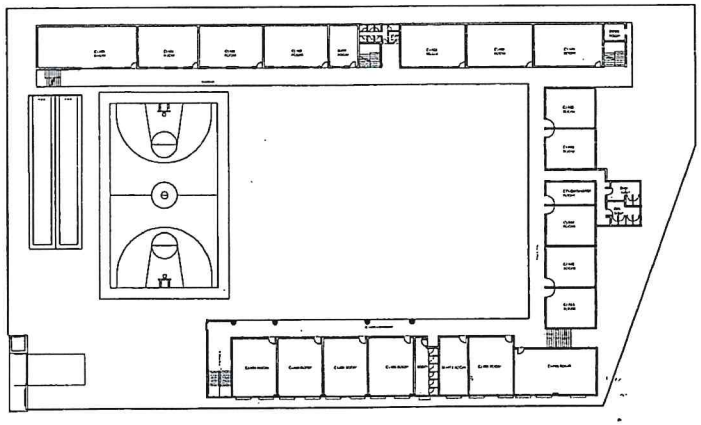

03 SECOND FLOOR PLAN
SCALE: NTS

BLOCK	Length		Breadth		FLOOR				
					GROUND	FIRST	SECOND	THIRD	TOTAL
BLOCK 1	283.50	X	28.25	=	8008.88	8008.88	8008.88	8008.88	32035.50
BLOCK 2	31.50	X	118.00	=	3717.00	3717.00	3717.00	3717.00	14868.00
BLOCK 3	20.50	X	22.50	=	461.25	461.25	461.25	461.25	1845.00
BLOCK 4	32.00	X	22.25	=		712.00	712.00	712.00	2136.00
BLOCK 5	147.00	X	36.00	=	5292.00	5292.00	5292.00	5292.00	21168.00
double height	64.83	X	28.00	=		-1815.24			-1815.24
BLOCK 6	34.50	X	36.00	=	1242.00				1242.00
				ft	18721.13	16375.89	18191.13	18191.13	71479.26

Principal
Glentree Academy, Whitefield
CBSE Affiliation No.830349 & School Code:45471
Nallurahalli, Whitefield Post,
Bangalore - 560066 Karnataka
Email: principal.whitefield@glentreeacademy.com
Mob:7899738132

NORTH

N

GENERAL NOTES

1. DRAWINGS NOT BE SCALED
2. READ IN CONJUCTION WITH STRUCTURAL DRAWINGS
3. ARCHITECT TO BE CONTACTED IN CASE OF DISCRIPANCY BETWEEN SPECIFICATIONS & DRAWINGS
4. ALL LEVELS FROM FFL (FINISHED FLOOR LEVEL)
5. ALL DIMENSIONS ARE IN METERS
6. FOR COLUMN LOCATION PLEASE REFER STRUCTURAL DRAWINGS
7. SEPTIC TANK, BOREWELL AND SOAKPIT LOCATED AS PER SITE CONDITIONS
8. ALL RCC, SSM/MS TRUSS AS PER DETAILED DRAWINGS
9. COLUMN POSITIONS SUBJECT TO CHANGE AS PER STRUCTURAL DRAWINGS
10. FLOOR LEVELS SUBJECT TO CHANGE AS PER SITE CONDITIONS.

AREA STATEMENT: IN SQUARE FEET

SITE AREA	=	55250.64
GROUND FLOOR	=	18721.13
FIRST FLOOR	=	16375.89
SECOND FLOOR	=	18191.13
THIRD FLOOR	=	18191.13
TOTAL BUILT-UP AREA	=	71479.26
FAR	=	1.29
COVERAGE	=	26.19%

REV	DATE	REVISION NOTE

LEGEND

- 200 MM THK WALL
- 100 MM THK WALL
- STRUCTURAL BEAM/SLAB
- RETAINING WALL
- NATURAL EARTH

PROJECT TITLE: AS BUILT DRAWING FOR GLENTREE SCHOOL AT WHITEFIELD, BANGALORE

CLIENT: GLENTREE ACADEMY

STRUCTURAL CONSULTANTS:

SIGNATURE/SIGN:

ARCHITECTS:
ALUR & ASSOCIATES
NO 3, 14TH MAIN ROAD VASANTHNAGAR
BANGALORE 560 001
PH: 2235-6234 EMAIL: design@alurassociates.com

TITLE: AS BUILT DRAWING

PURPOSE: FOR SANCTION

DATE:	SCALE:	CHECKED BY:
25.04.2022	NTS	SATEJ ALUR
DRAWN BY: JYOTHI	DEALT BY: ALUR	

DRAWING NO: AA/GL/WF/A-101

REV NO: R0